


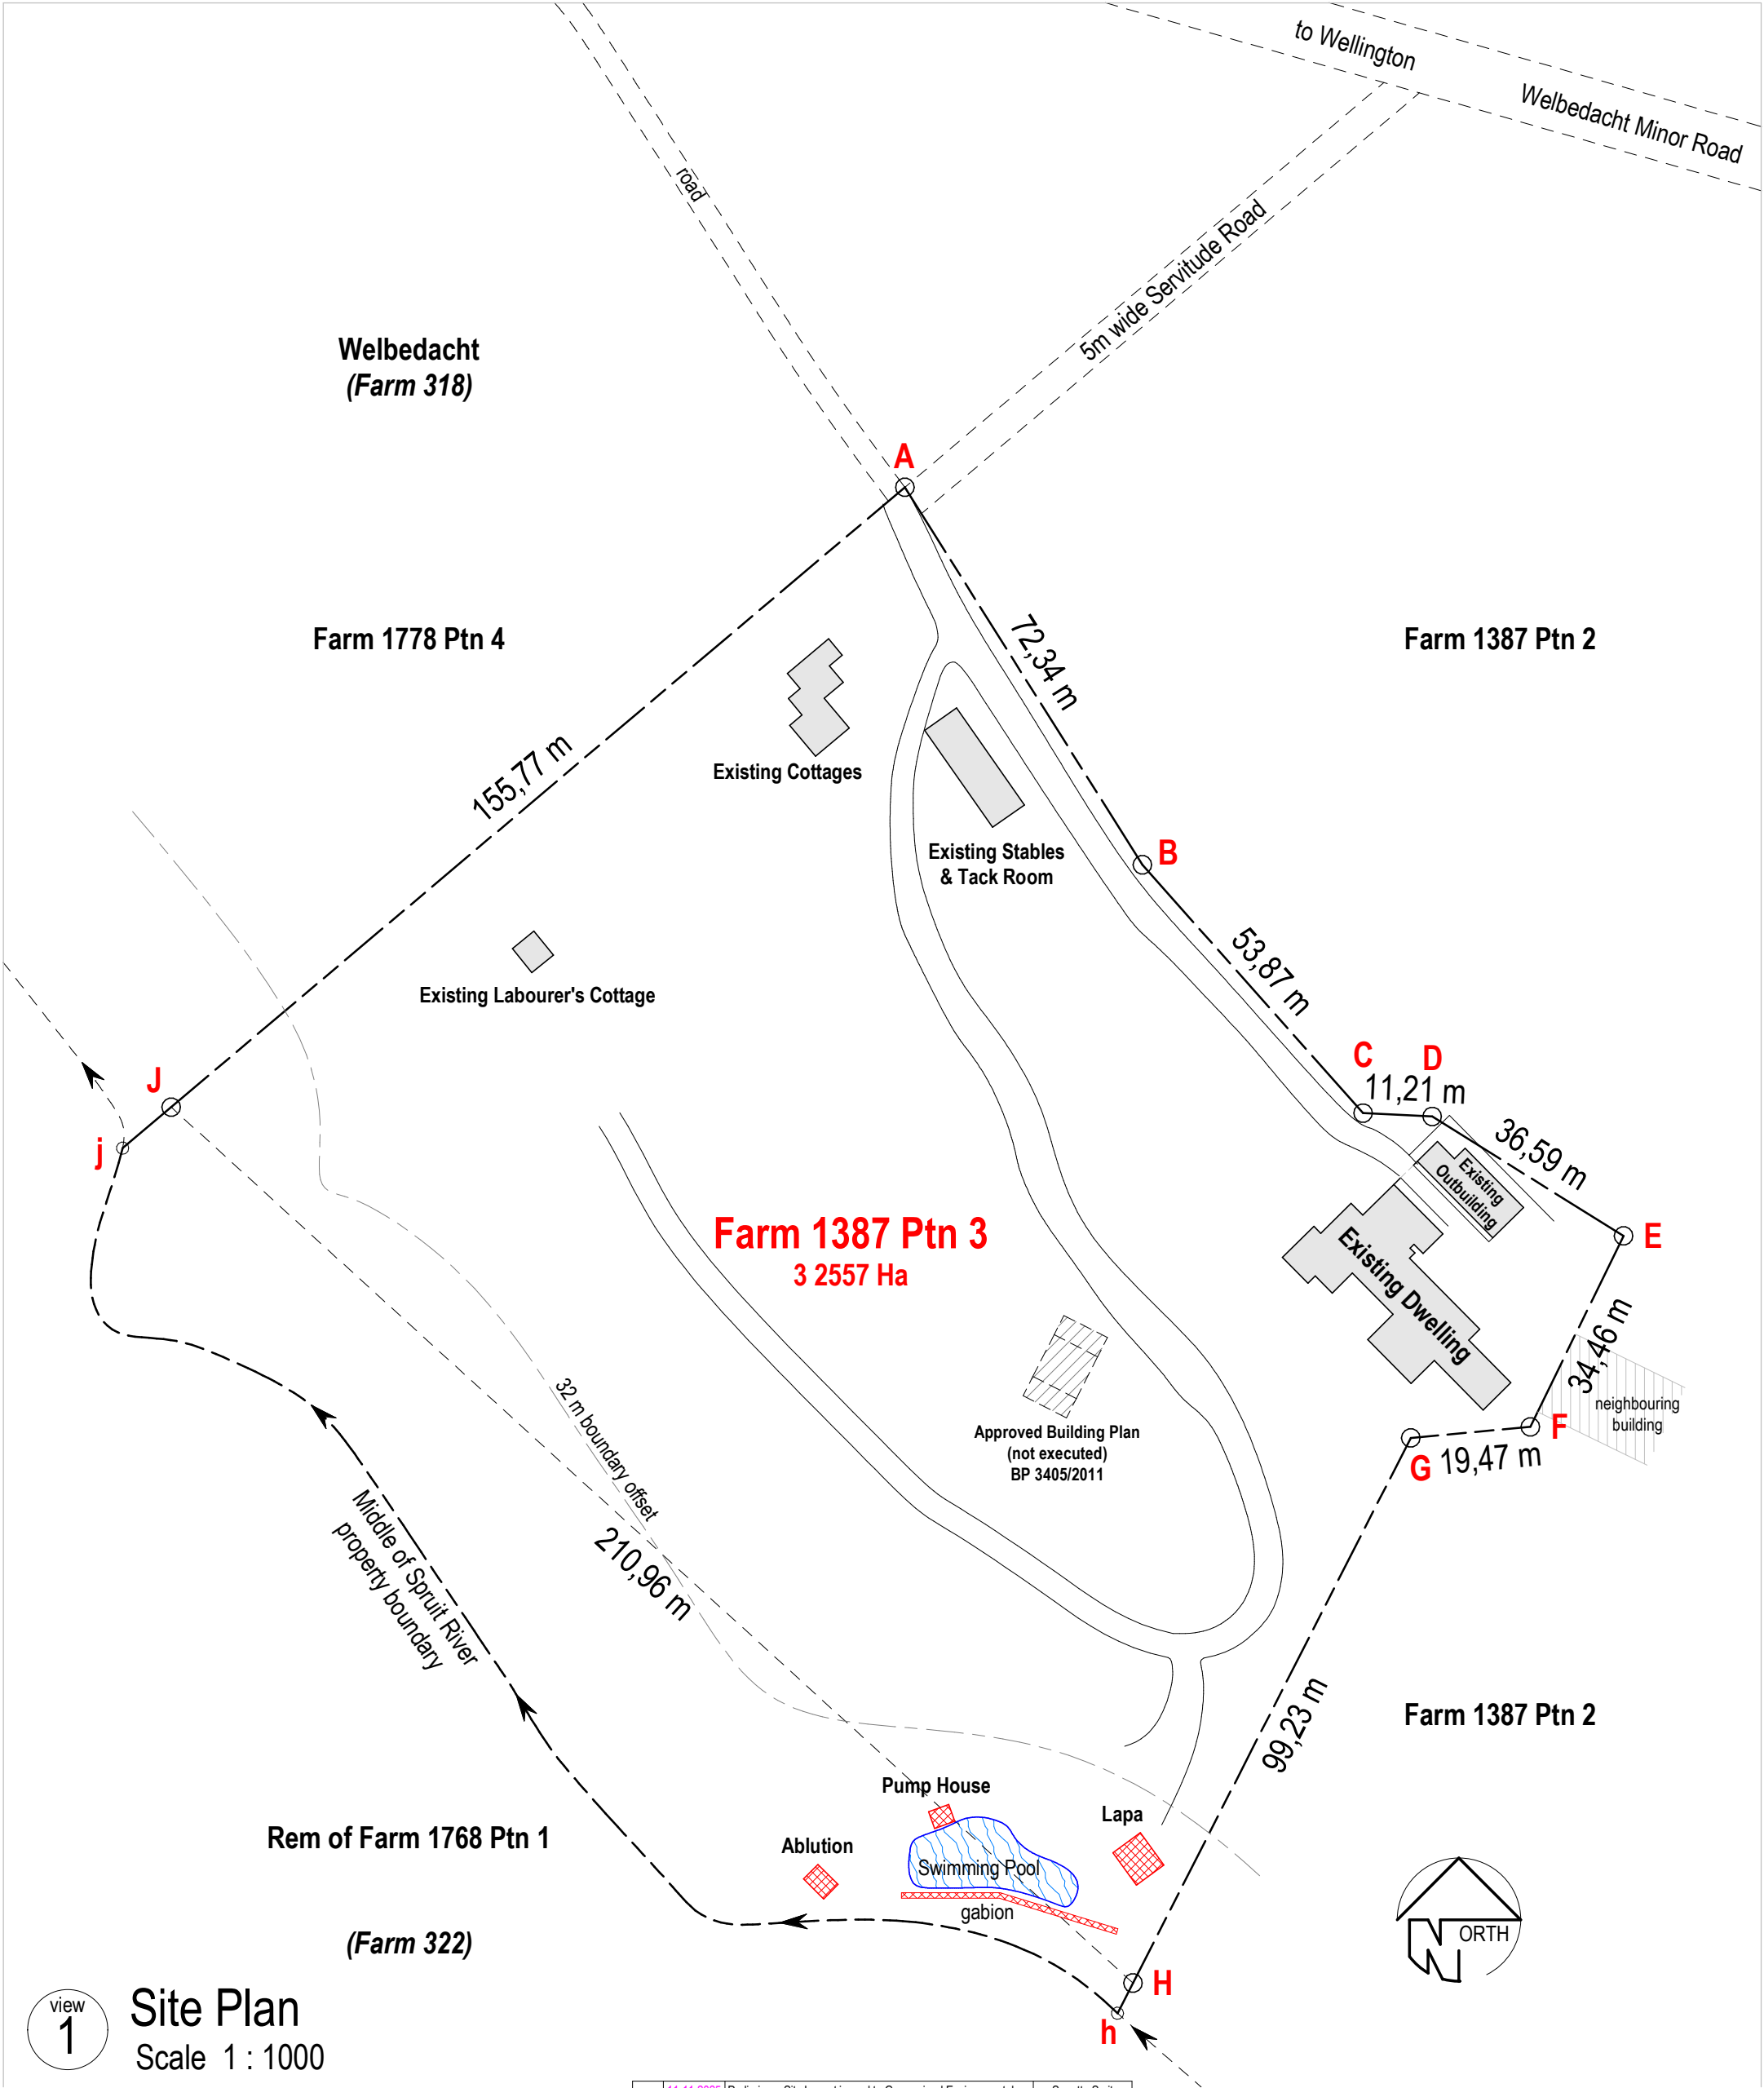

view
1

Site Plan
Scale 1 : 1000

Rev	Rev Date	Description	Issued to
11-11-2025		Preliminary Site Layout issued to Greenmined Environmental	Sonette Smit



architecture
148 genl hertzog blvd
wellington 7655

T 021 864 2010
M 083 384 0246
E info@smitdesign.co.za

[Signature]

Eden Farm

As-Built Structures

Farm 1387 Ptn 3 Wellington

Preliminary Site Layout			
Design	others	Issued for Discussion	11-11-2025
Drawn	H Smit		
Scale	(A3) 1 : 1000	Sheet no	P.01
Project		1238	
Rev.			